


NOTES:
 SUBJECT TO STATUTORY CONSENTS
 SUBJECT TO SURVEY
 BASED ON OS MAP REPRODUCED BY PERMISSION OF CONTROLLER OF HM STATIONARY OFFICE (c) CROWN COPYRIGHT
 COPYRIGHT RESERVED
 DO NOT SCALE THIS DRAWING
 DO NOT USE ELECTRONIC VERSIONS OF THIS DRAWING TO DETERMINE DIMENSIONS UNLESS SPECIFICALLY AUTHORISED BY MICHAEL SPARKS ASSOCIATES
 IF USING AN ELECTRONIC VERSION OF THIS DRAWING FIGURED DIMENSIONS TAKE PRECEDENCE AND NOTIFY MICHAEL SPARKS ASSOCIATES OF ANY DISCREPANCIES

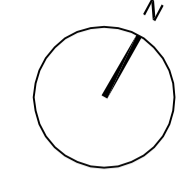

NOTE:
 PROVIDE ONE HOUR FIRE PROTECTION TO UPPER FLOOR CONSTRUCTION AND ONE HOUR FIRE PROTECTION TO SUPPORTING STRUCTURE.
 COMPLY WITH ALL PARTS OF APPROVED DOCUMENTS IN PARTICULAR PART B, PART L2 AND PART M.
 FOR STRUCTURAL DOOR OPENINGS REFER TO SEC DOOR SCHEDULE
 MOISTURE RESISTANT PLASTERBOARD TO BE USED THROUGHOUT WCs

AS BUILT

THIS "AS-BUILT" DRAWING IS BASED ON INFORMATION SUPPLIED TO MICHAEL SPARKS ASSOCIATES BY MC LAREN CONSTRUCTION AND INCORPORATES INSTRUCTIONS AND OTHER DESIGN INFORMATION GIVEN TO MC LAREN CONSTRUCTION DIRECTLY BY OTHERS


REV	DATE	NOTE	DRAW	CHK
A	30.03.2009	Refer to sub-contractors drawings for specialist details This supercedes drawing no: 2716/EL/260 rev.L	JH	NSC

MICHAEL SPARKS ASSOCIATES
 CHARTERED ARCHITECTS
 11 PLATO PLACE
 ST. DION'S ROAD
 LONDON SW6 4TU
 TELEPHONE 020 7736 6162
 FAX 020 7736 3896
 www.msa-architects.co.uk


FROGMORE

TITLE
CROSSWAYS, DARTFORD
 DRAWING
LAKEVIEW WEST OFFICE
CORE - GROUND & FIRST FLOOR PLANS
 CLIENT
FROGMORE

DATE	SCALE	DRAWN
MARCH 2009	1:50 @ A1	JH
	STATUS	CHECKED
	AS BUILT	NSC
DRAWING NUMBER 2716 / AB / 1022 A		

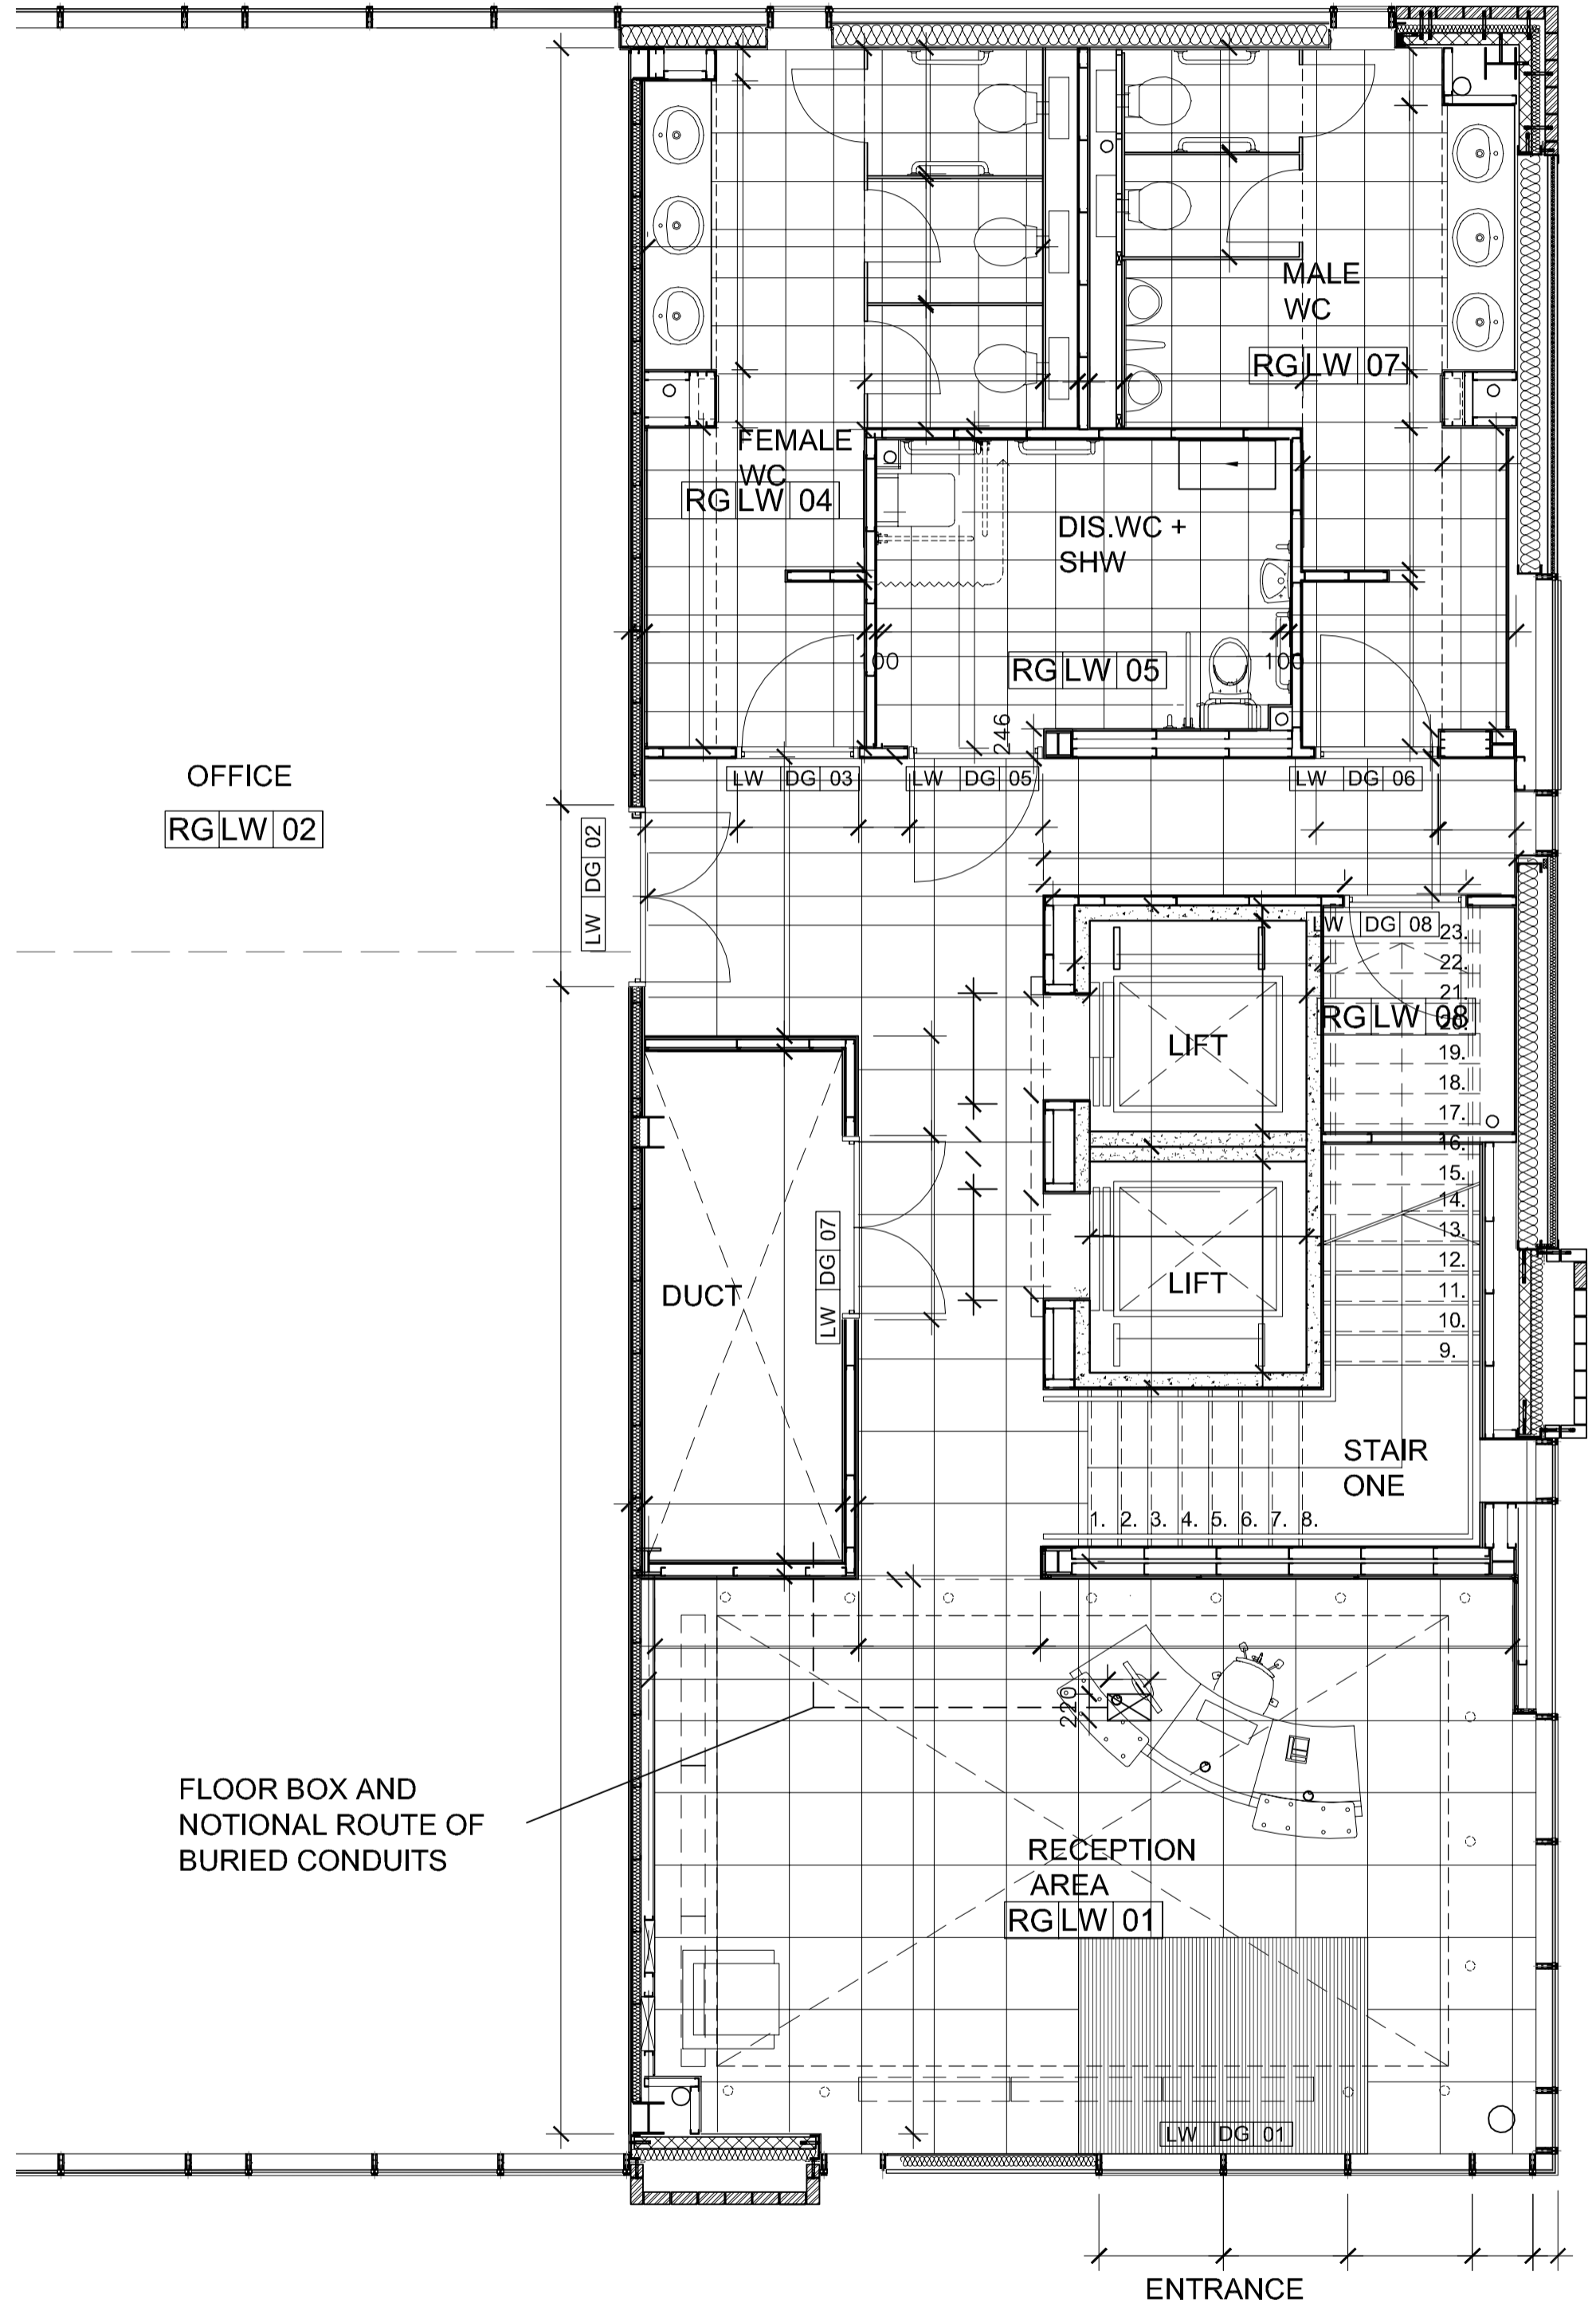

01
1022 LAKEVIEW WEST OFFICE - CORE GROUND FLOOR PLAN
1:50

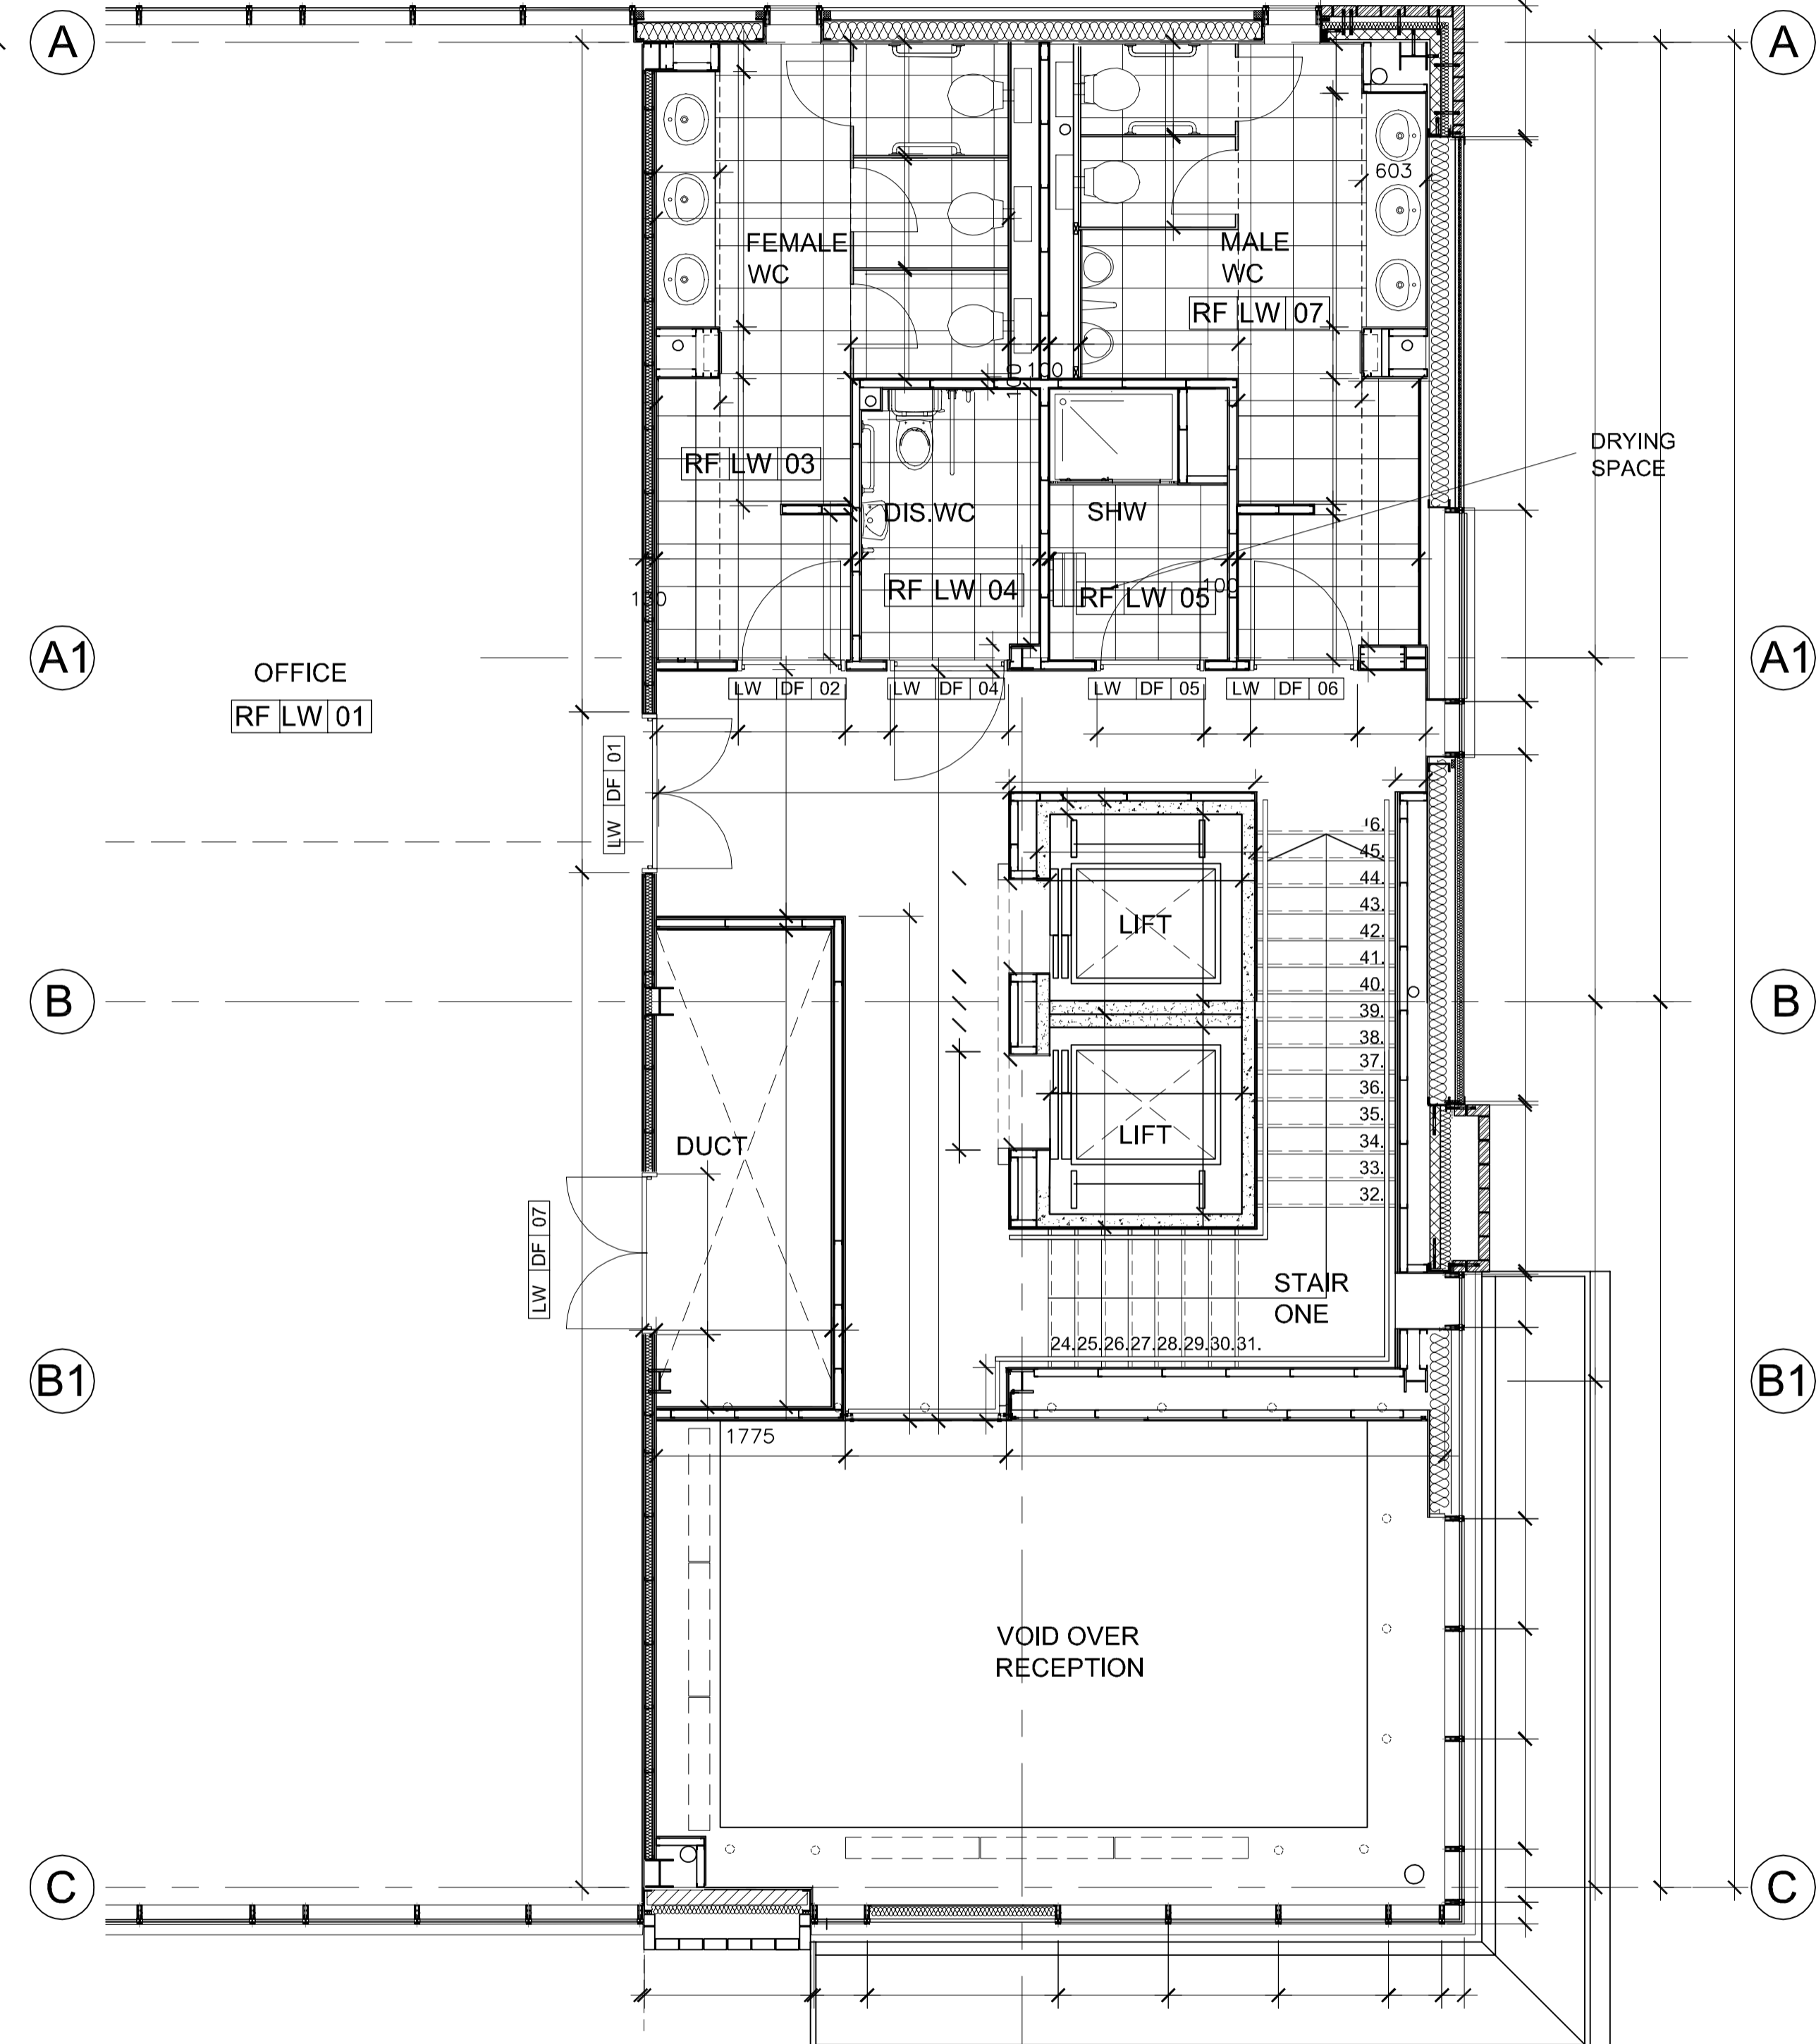

02
1022 LAKEVIEW WEST OFFICE - CORE FIRST FLOOR PLAN
1:50

ENSURE SEALING OF ALL JUNCTIONS TO COMPLY WITH PART L.

NOTE:
 ROOF AND WALL CLADDING TO BE DESIGNED BY SPECIALIST CONTRACTOR.
 CLADDING DETAILS TO BE READ IN CONJUNCTION WITH THE SPECIFICATION AND ALL RELEVANT BRITISH STANDARDS.
 INCLUDE VAPOUR BARRIER TAPE AROUND ALL OPENINGS AND JUNCTIONS.

ALL DIMENSIONS TO BE CHECKED ON SITE.
 STEEL COLUMN SIZES TO BE CONFIRMED AND TOLERANCES TO BE AGREED.