




01 LAKEVIEW WEST OFFICE - NORTH ELEVATION
1011 1:100

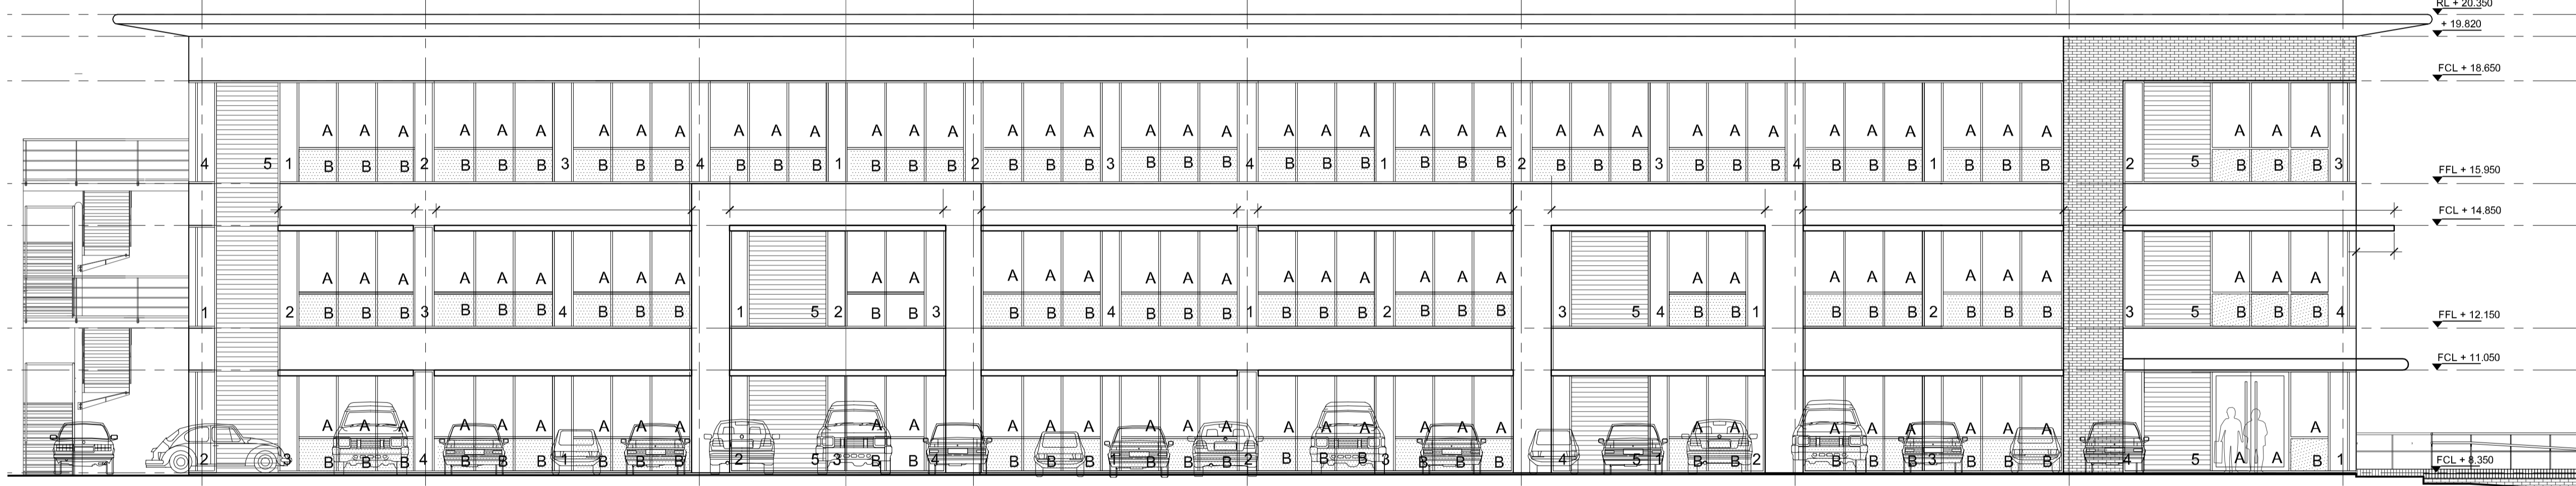

02 LAKEVIEW WEST OFFICE - SOUTH ELEVATION
1011 1:100

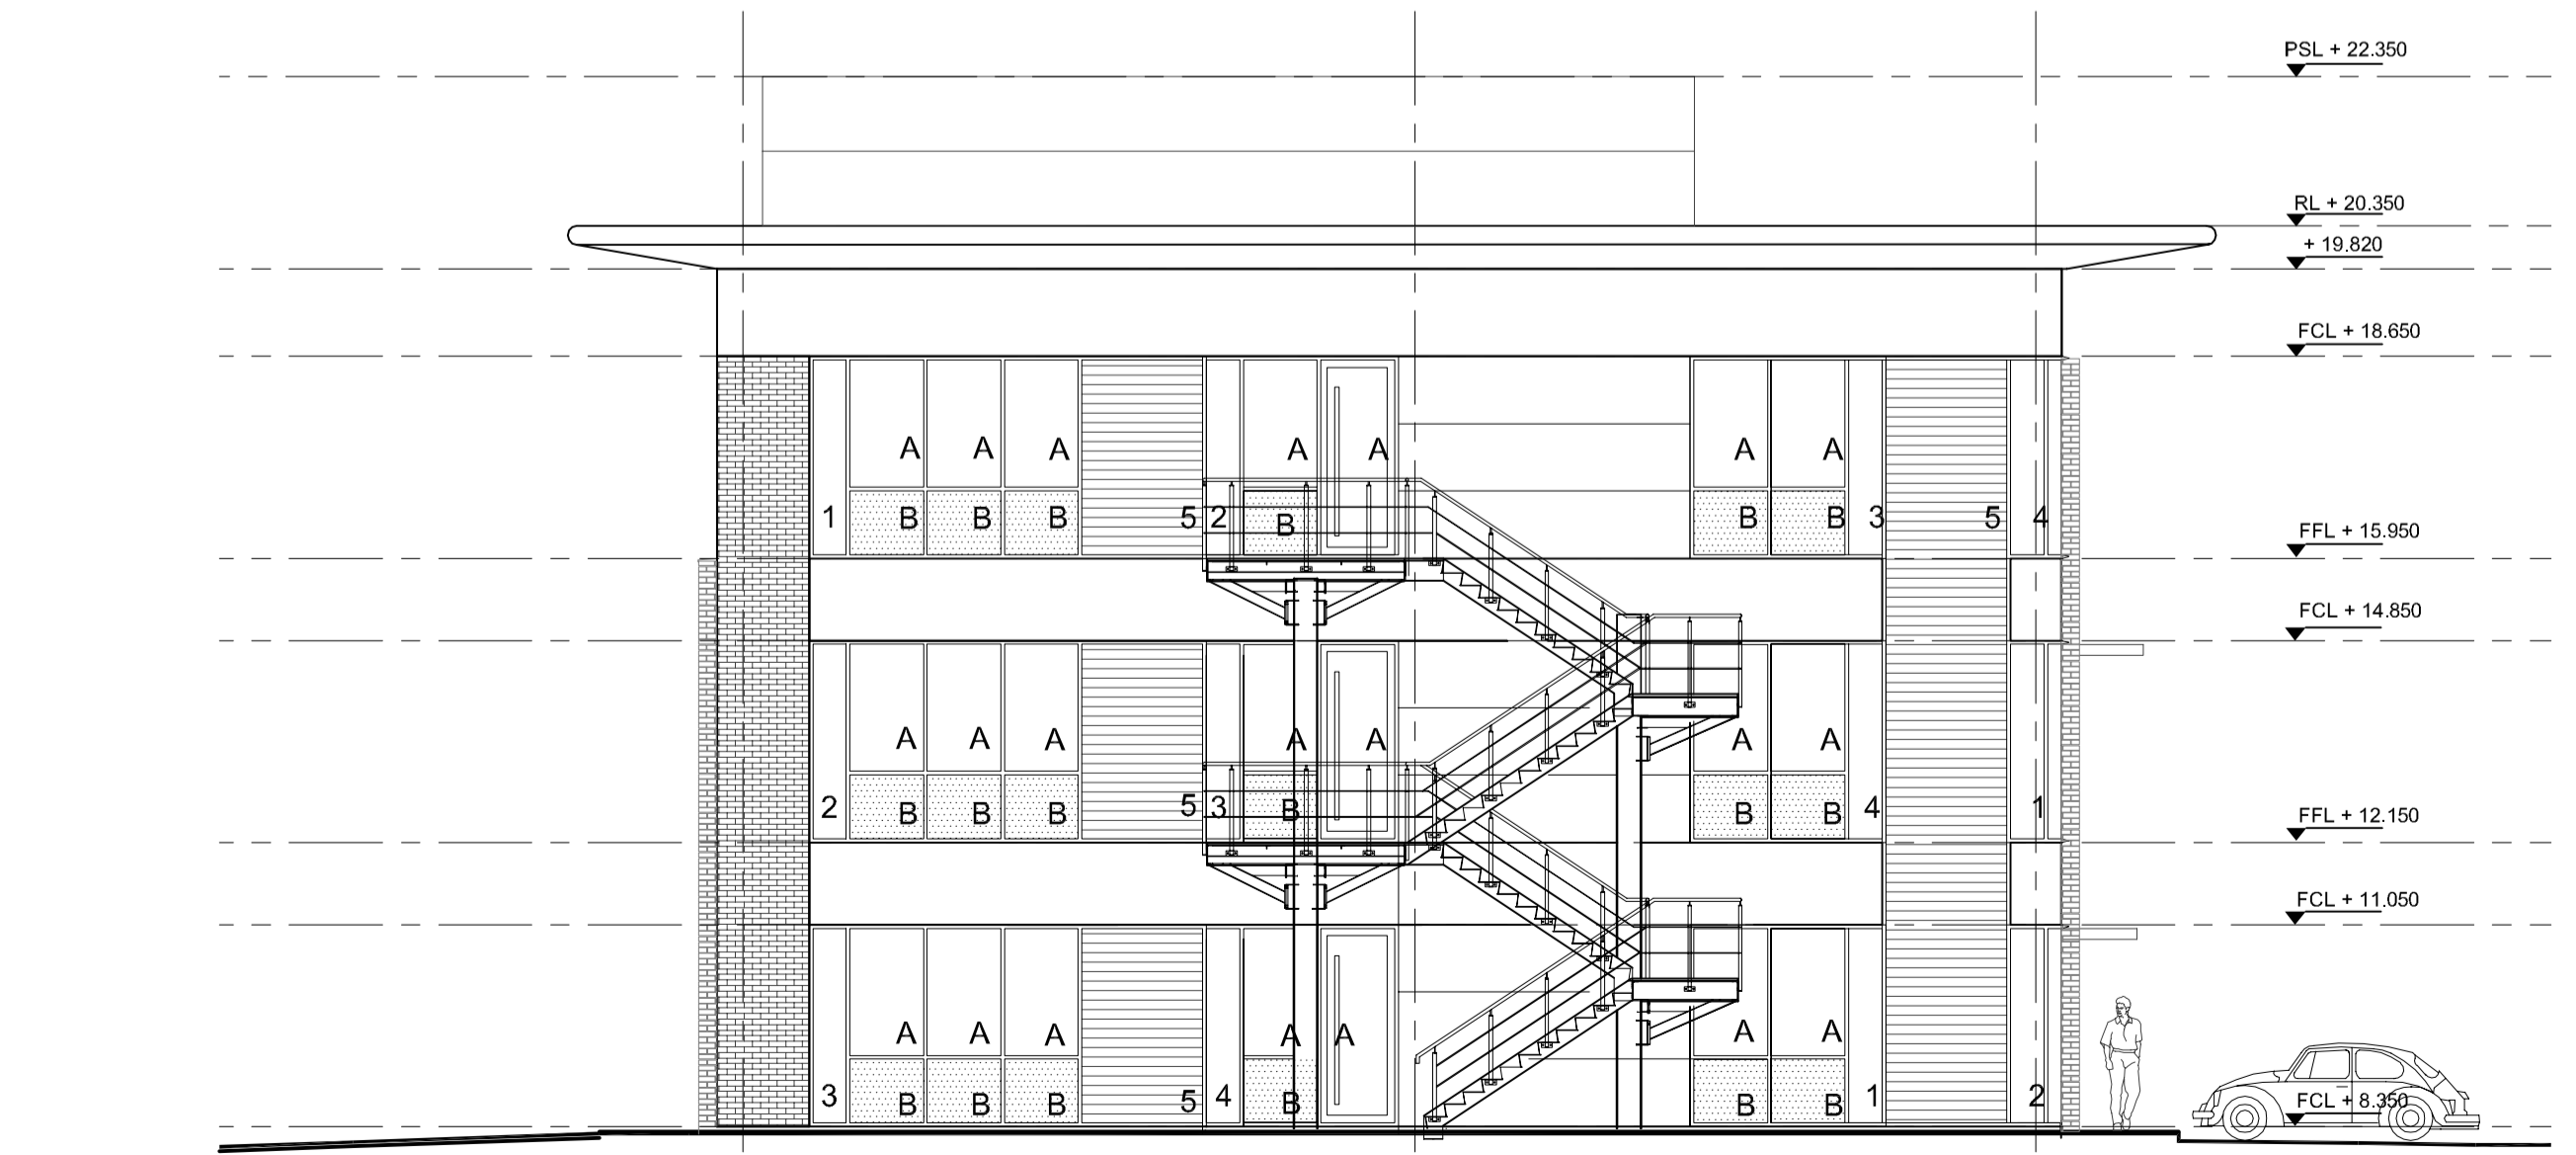

03 LAKEVIEW WEST OFFICE - WEST ELEVATION
1011 1:100

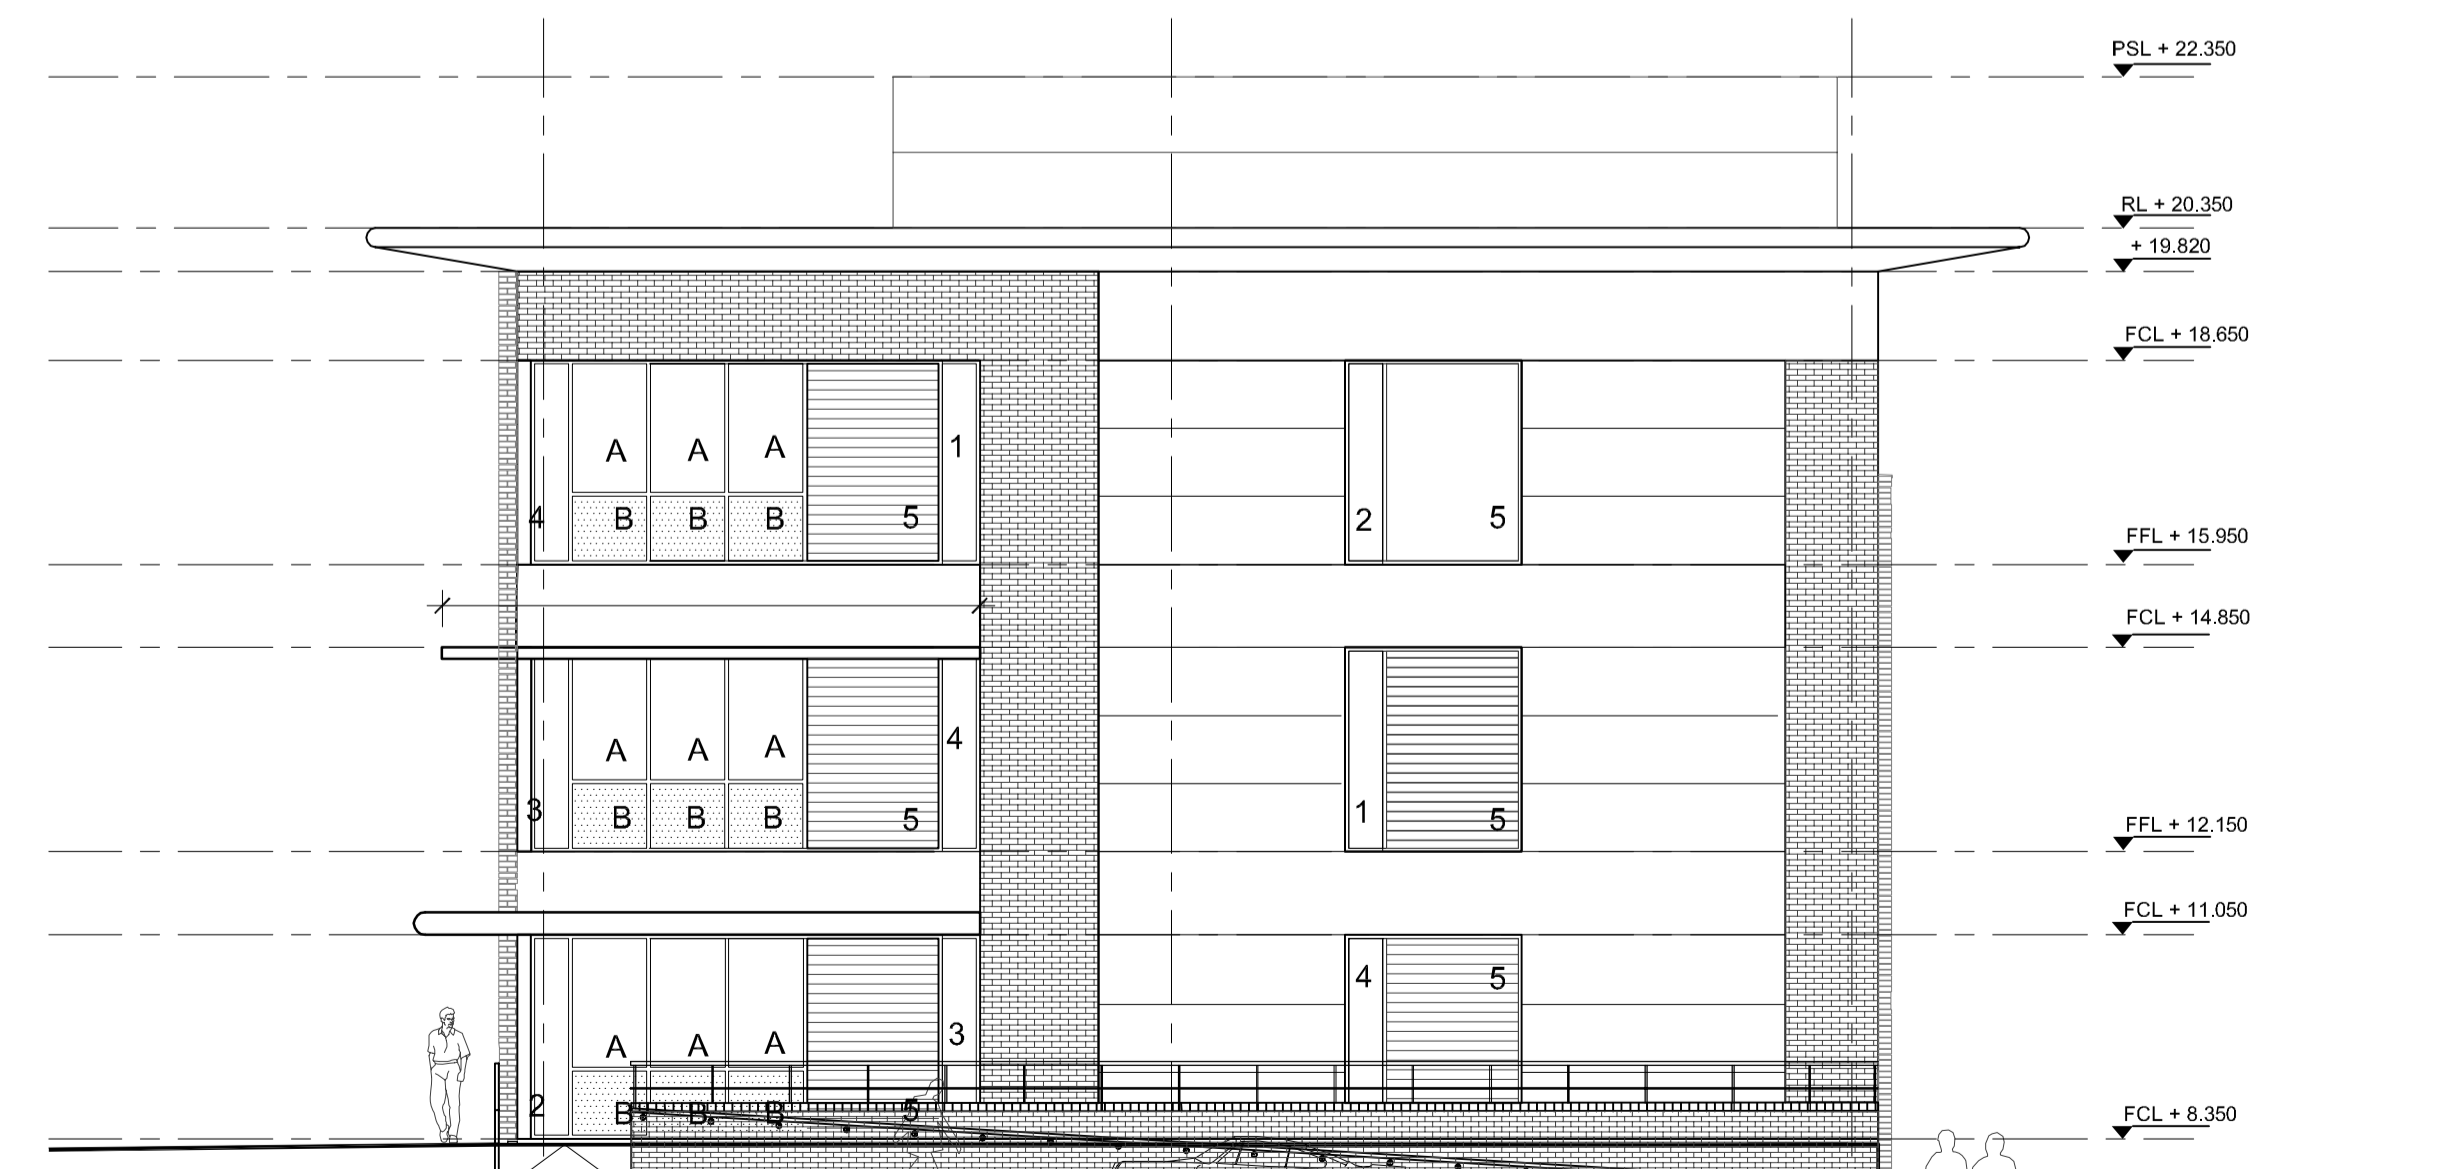

04 LAKEVIEW WEST OFFICE - EAST ELEVATION
1011 1:100

NOTES:
 SUBJECT TO STATUTORY CONSENTS
 SUBJECT TO SURVEY
 BASED ON OS MAP REPRODUCED BY PERMISSION OF CONTROLLER OF HM STATIONARY OFFICE (c) CROWN COPYRIGHT
 DO NOT SCALE THIS DRAWING
 COPYRIGHT RESERVED
 DO NOT USE ELECTRONIC VERSIONS OF THIS DRAWING TO DETERMINE DIMENSIONS UNLESS SPECIFICALLY AUTHORISED BY MICHAEL SPARKS ASSOCIATES
 IF USING AN ELECTRONIC VERSION OF THIS DRAWING FIGURED DIMENSIONS TAKE PRECEDENCE AND NOTIFY MICHAEL SPARKS ASSOCIATES OF ANY DISCREPANCIES


ENSURE SEALING OF ALL JUNCTIONS TO COMPLY WITH PART L

NOTE:
 ROOF AND WALL CLADDING TO BE DESIGNED BY SPECIALIST CONTRACTOR
 CLADDING DETAILS TO BE READ IN CONJUNCTION WITH THE SPECIFICATION AND ALL RELEVANT BRITISH STANDARDS
 INCLUDE VAPOUR BARRIER TAPE AROUND ALL OPENINGS AND JUNCTIONS

ALL DIMENSIONS TO BE CHECKED ON SITE.
 STEEL COLUMN SIZES TO BE CONFIRMED AND TOLERANCES TO BE AGREED.

- A 6mm CLEAR LOW E-GLASS TOUGHENED
16mm ARGON SPACER COMPRISING 90% ARGON
6.4mm SOFT COAT LAMINATED
- B 6mm SATIN SANDBLASTED TOUGHENED
16mm ARGON SPACER COMPRISING 90% ARGON
6.4mm SOFT COAT LAMINATED
- 1 6.8mm VANCEVA LAMINATED BLUE GLASS TOUGHENED
PANE - REF TRUE BLUE
16mm ARGON SPACER COMPRISING 90% ARGON
6mm CLEAR LOW E-GLASS TOUGHENED
- 2 6.8mm VANCEVA LAMINATED BLUE GLASS TOUGHENED
PANE - REF AQUAMARINE
16mm ARGON SPACER COMPRISING 90% ARGON
6mm CLEAR LOW E-GLASS TOUGHENED
- 3 6.8mm VANCEVA LAMINATED BLUE GLASS TOUGHENED
PANE - REF SAPPHIRE
16mm ARGON SPACER COMPRISING 90% ARGON
6mm CLEAR LOW E-GLASS TOUGHENED
- 4 6.8mm VANCEVA LAMINATED BLUE GLASS TOUGHENED
PANE - REF 6166
16mm ARGON SPACER COMPRISING 90% ARGON
6mm CLEAR LOW E-GLASS TOUGHENED
- 5 HORIZONTALLY LAID TREATED CEDAR
RAINSCREEN PANELS

<h1>AS BUILT</h1>			
THIS "AS-BUILT" DRAWING IS BASED ON INFORMATION SUPPLIED TO MICHAEL SPARKS ASSOCIATES BY MC LAREN CONSTRUCTION AND INCORPORATES INSTRUCTIONS AND OTHER DESIGN INFORMATION GIVEN TO MC LAREN CONSTRUCTION DIRECTLY BY OTHERS			
A	30.03.2009 Refer to sub-contractors drawings for specialist details This supercedes drawing no: 2716/RE/303 rev.H	JH	NSC
REV	DATE	NOTE	DRAW CHCK



CHARTERED ARCHITECTS
 11 PLATO PLACE
 ST. DUNGS ROAD
 LONDON SW6 4TU
 TELEPHONE 020 7736 6162
 FAX 020 7736 3896
 www.msa-architects.co.uk

FROGMORE

TITLE
CROSSWAYS, DARTFORD

DRAWING
LAKEVIEW WEST OFFICE ELEVATIONS

CLIENT
FROGMORE

DATE	SCALE	DRAWN
MARCH 2009	1:100 @ A1	JH
	STATUS	CHECKED
	AS BUILT	NSC

DRAWING NUMBER
2716 / AB / 1011 A