

01 UNIT 1-4 SECTION A - A
1:50

NOTES:

SUBJECT TO STATUTORY CONSENTS
SUBJECT TO SURVEY

BASED ON OS MAP REPRODUCED BY PERMISSION OF CONTROLLER OF HM STATIONARY OFFICE (c) CROWN COPYRIGHT
COPYRIGHT RESERVED

DO NOT SCALE THIS DRAWING

DO NOT USE ELECTRONIC VERSIONS OF THIS DRAWING TO DETERMINE DIMENSIONS UNLESS SPECIFICALLY AUTHORISED BY MICHAEL SPARKS ASSOCIATES


IF USING AN ELECTRONIC VERSION OF THIS DRAWING FIGURED DIMENSIONS TAKE PRECEDENCE AND NOTIFY MICHAEL SPARKS ASSOCIATES OF ANY DISCREPANCIES

ENSURE SEALING OF ALL JUNCTIONS TO COMPLY WITH PART L


U-Values:
Roof: 0.25
Floors: 0.25
Walls: 0.25
Glazing: 1.50

NOTE:
ROOF AND WALL CLADDING TO BE DESIGNED BY SPECIALIST CONTRACTOR.
CLADDING DETAILS TO BE READ IN CONJUNCTION WITH THE SPECIFICATION AND ALL RELEVANT BRITISH STANDARDS.
INCLUDE VAPOUR BARRIER TAPE AROUND ALL OPENINGS AND JUNCTIONS.

ALL DIMENSIONS TO BE CHECKED ON SITE.
STEEL COLUMN SIZES TO BE CONFIRMED AND TOLERANCES TO BE AGREED.

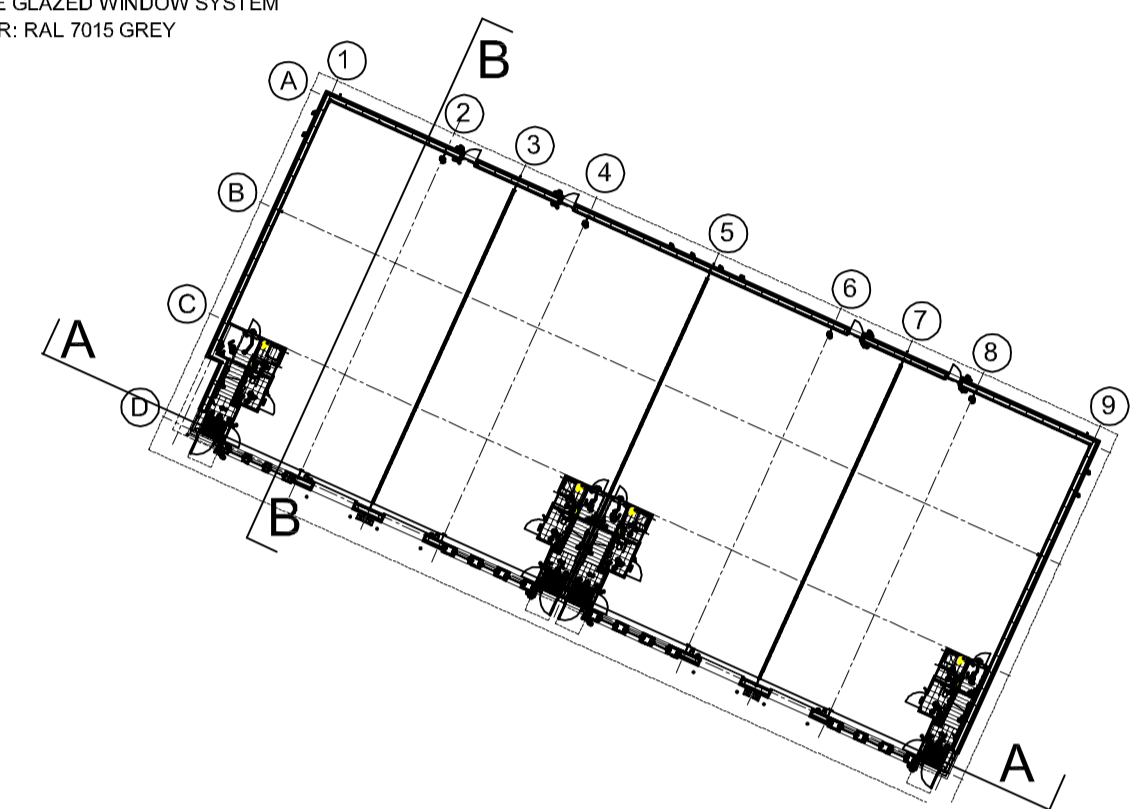

03 UNIT 1-4 GF PLAN
1:500

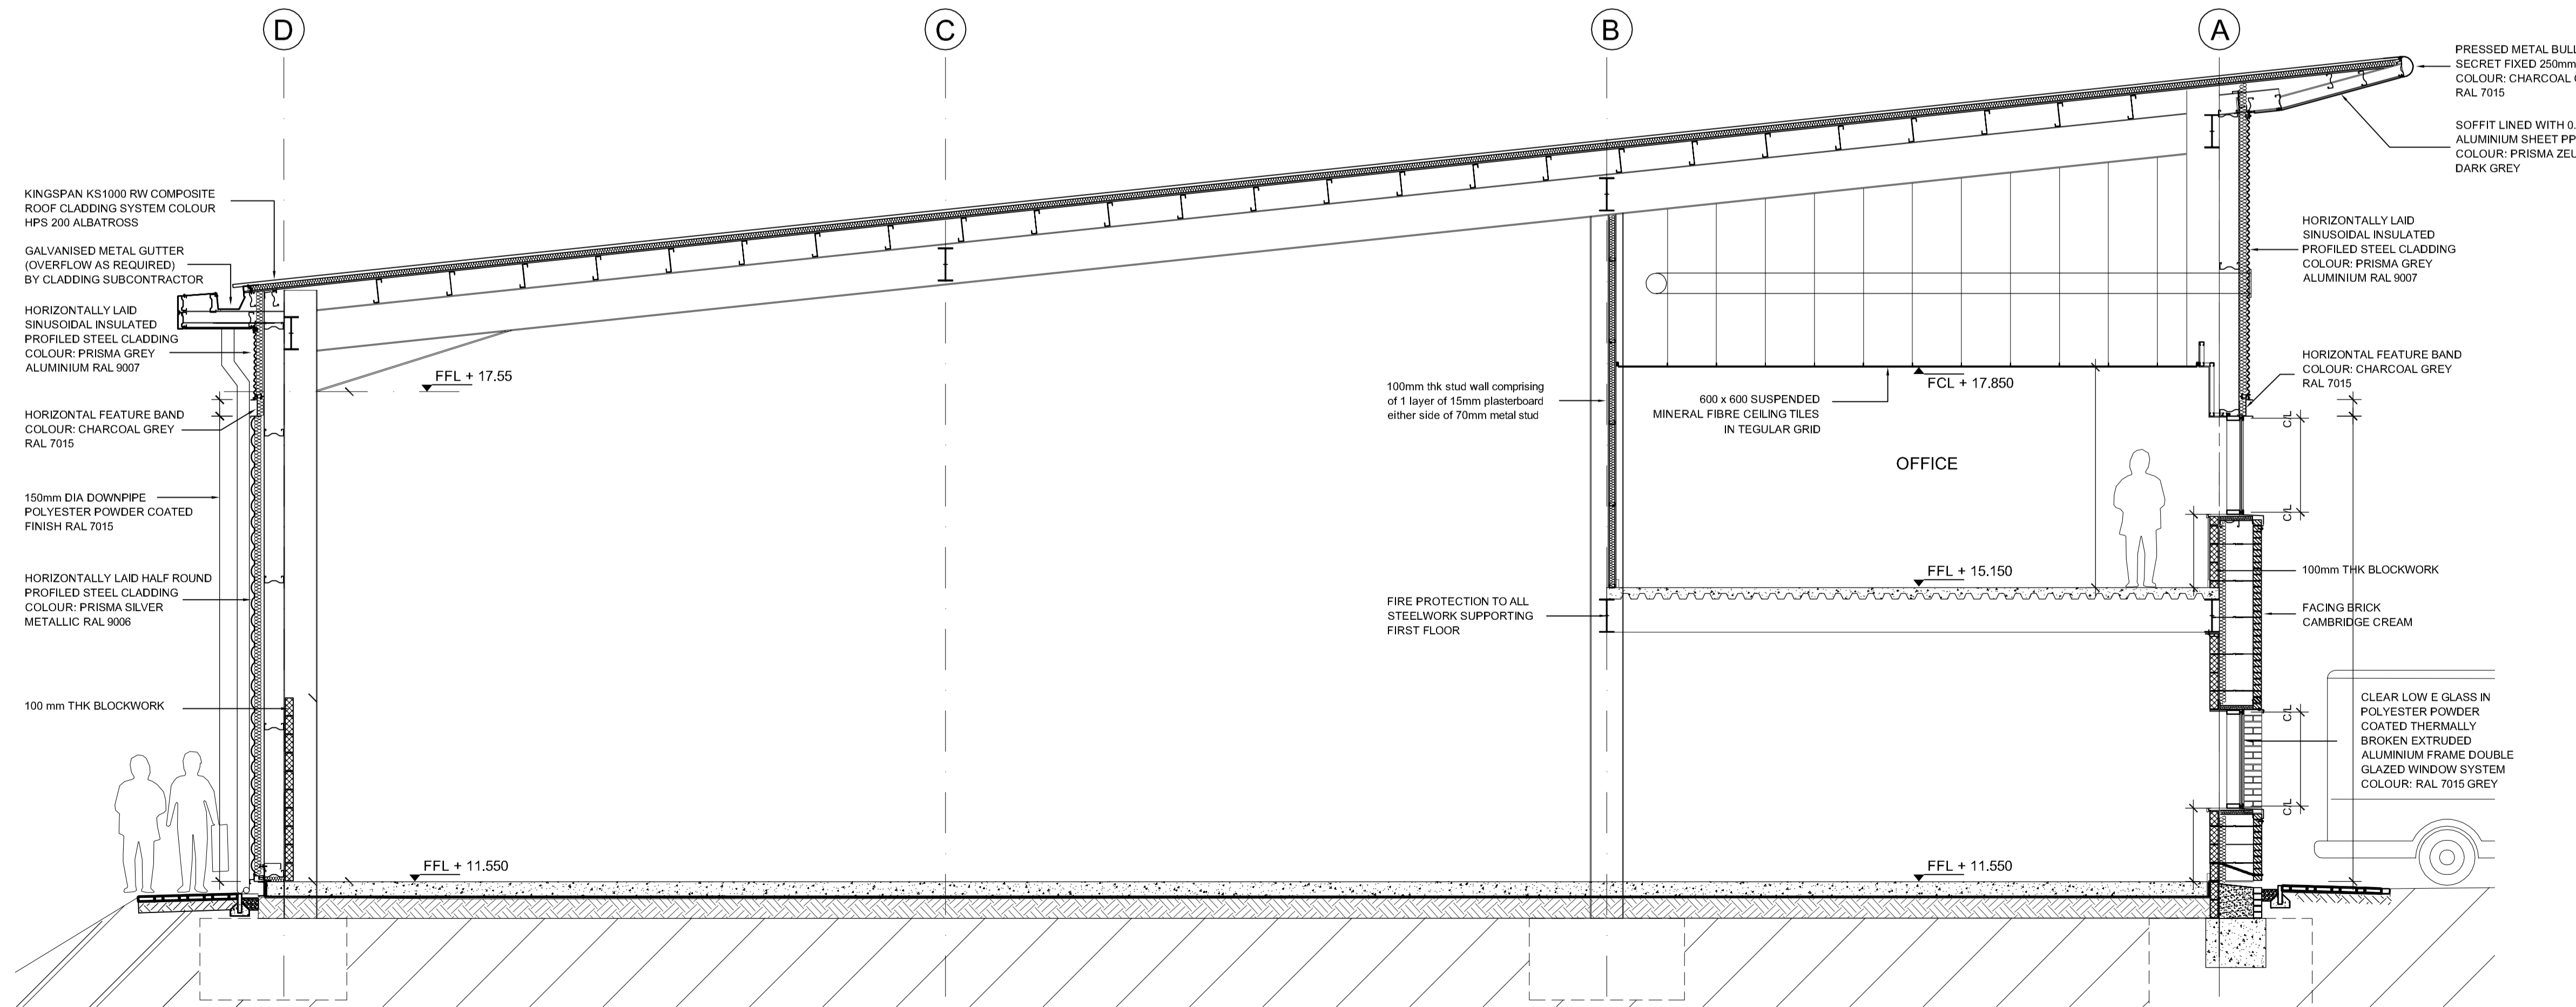

02 UNIT 1-4 SECTION B - B
1:50

AS BUILT			
THIS "AS-BUILT" DRAWING IS BASED ON INFORMATION SUPPLIED TO MICHAEL SPARKS ASSOCIATES BY MC LAREN CONSTRUCTION AND INCORPORATES INSTRUCTIONS AND OTHER DESIGN INFORMATION GIVEN TO MC LAREN CONSTRUCTION DIRECTLY BY OTHERS			
A	25.03.2009	Refer to sub-contractors drawings for specialist details This supercedes drawing no: 2716/RE/380 rev.D	JH NSC
REV	DATE	NOTE	DRAW CHCK

MICHAEL SPARKS ASSOCIATES
FROGMORE

CHARTERED ARCHITECTS
11 PLATO PLACE
ST. BONS ROAD
LONDON SW6 4TU
TELEPHONE 020 7736 6162
FAX 020 7736 3896
www.msa-architects.co.uk

TITLE
CROSSWAYS, DARTFORD

DRAWING
SCHOONER PARK UNITS 1-4 SECTIONS

CLIENT
FROGMORE

DATE	SCALE	DRAWN
MARCH 2009	1:50 @ A1	JH
	STATUS	CHECKED
	AS BUILT	NSC

DRAWING NUMBER
2716 / AB / 1220 A