




01 WATERSIDE COURT OFFICE 1-3 WEST ELEVATION  
1108 1:100

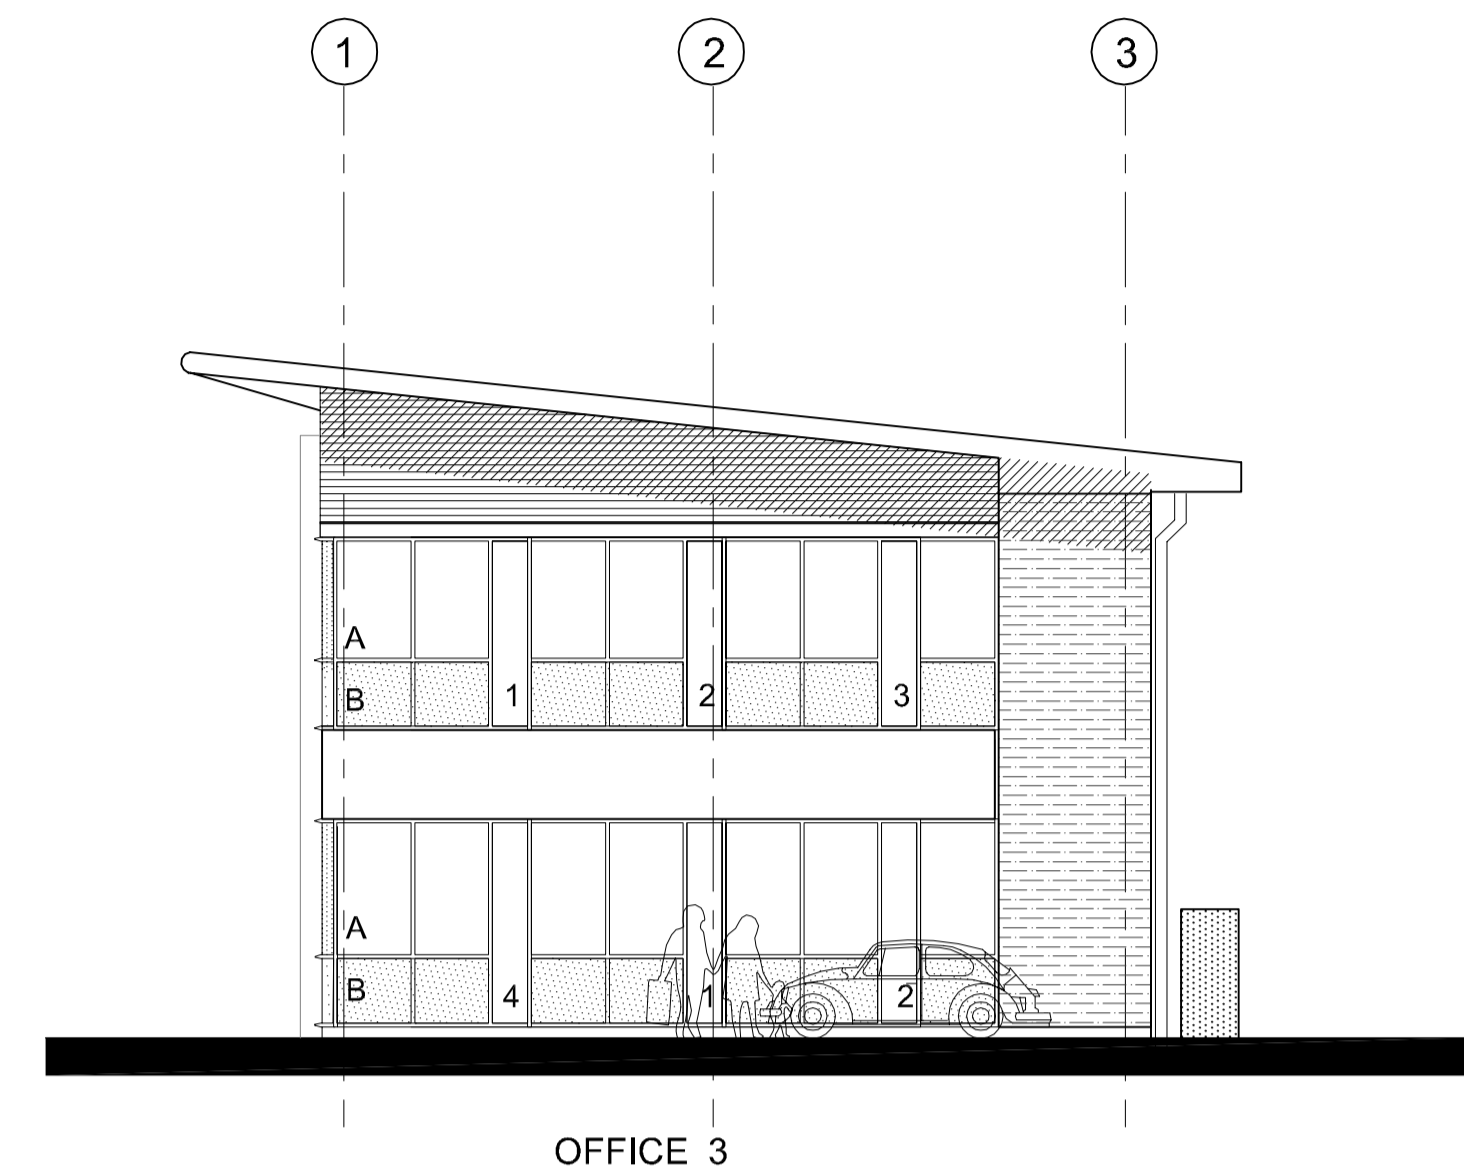

02 WATERSIDE COURT OFFICE 1-3 SOUTH ELEVATION  
1108 1:100

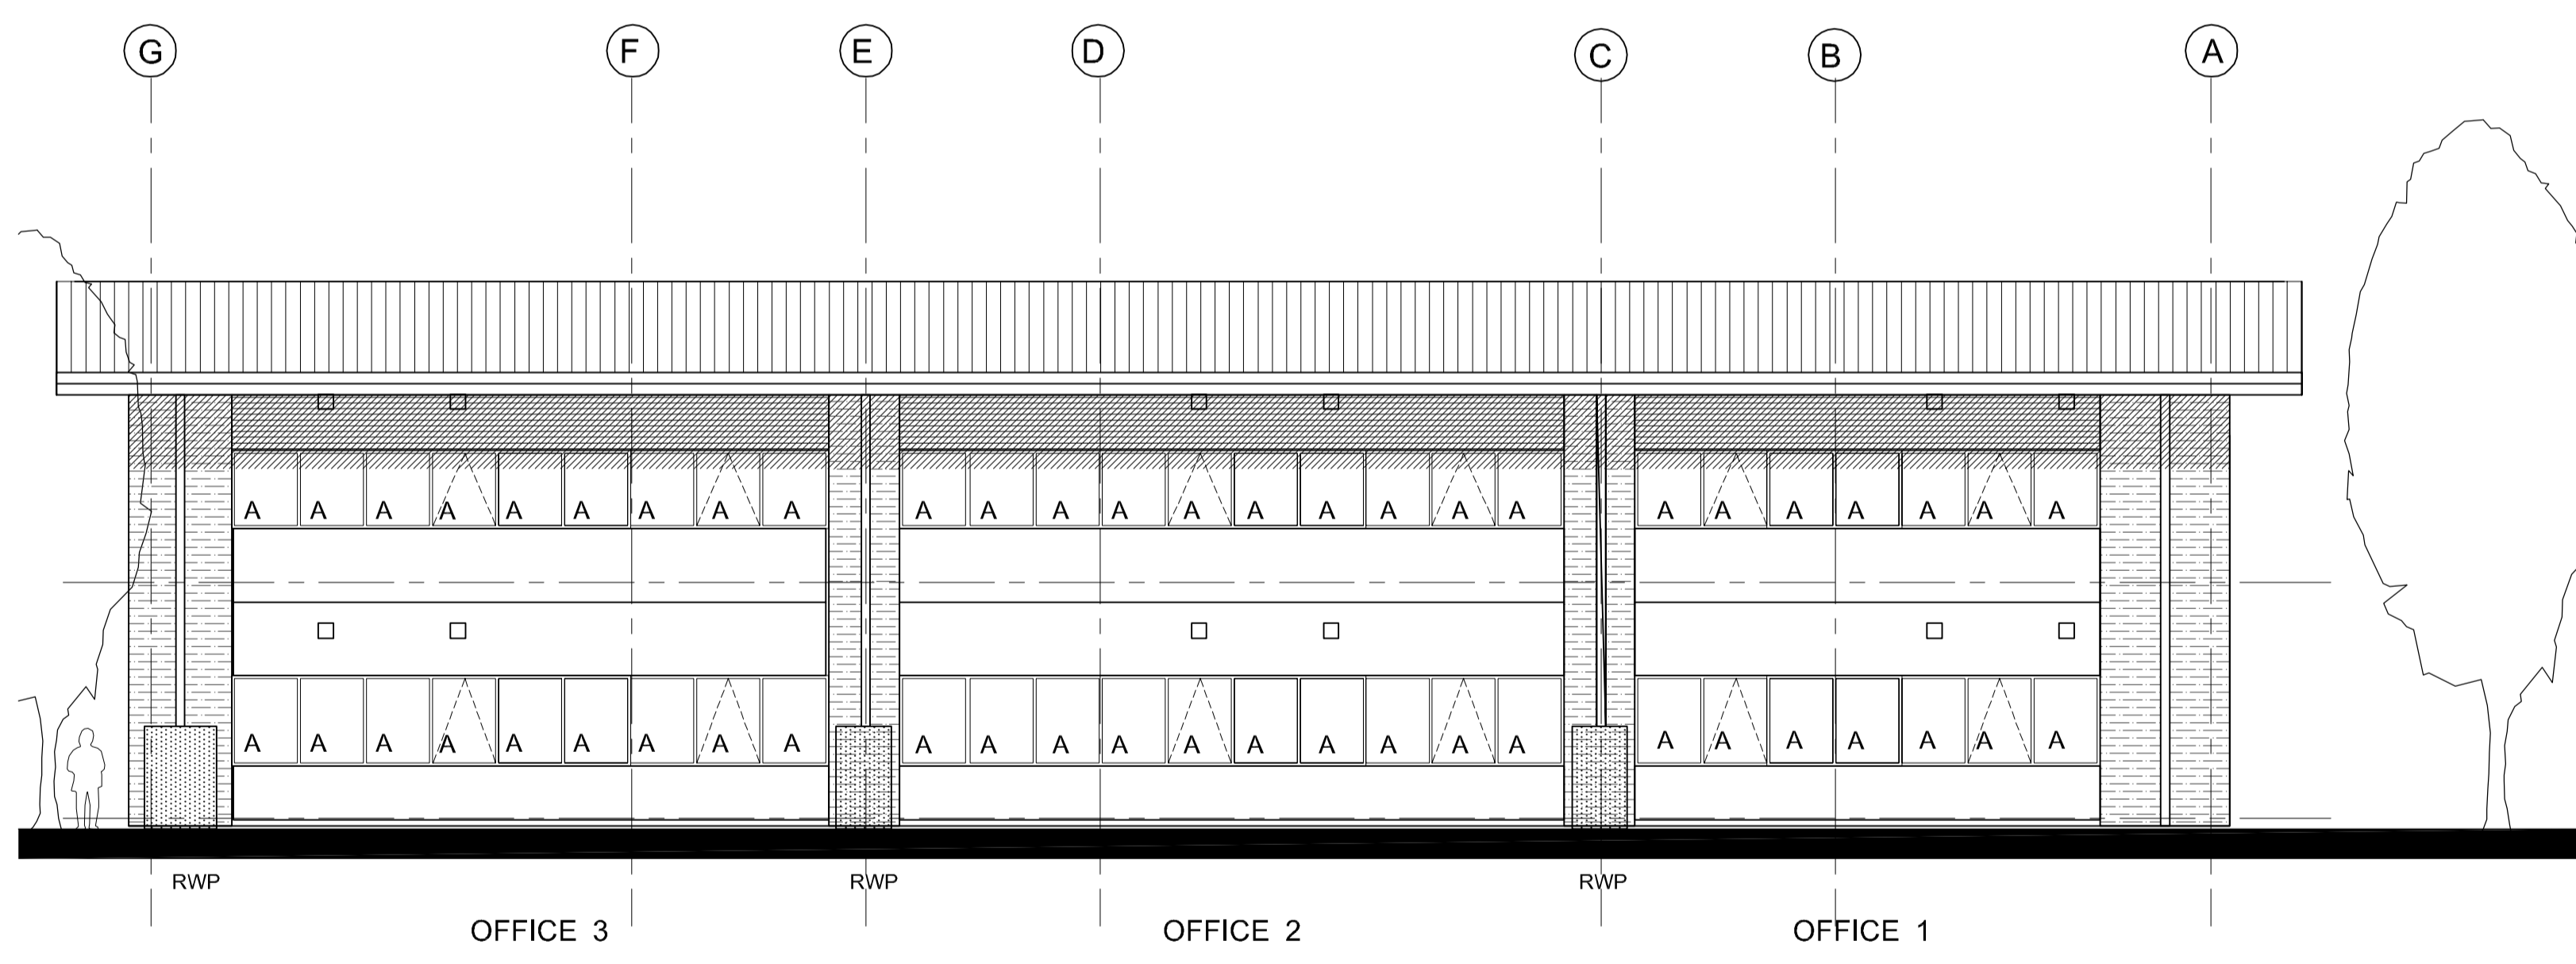

03 WATERSIDE COURT OFFICE 1-3 EAST ELEVATION  
1108 1:100

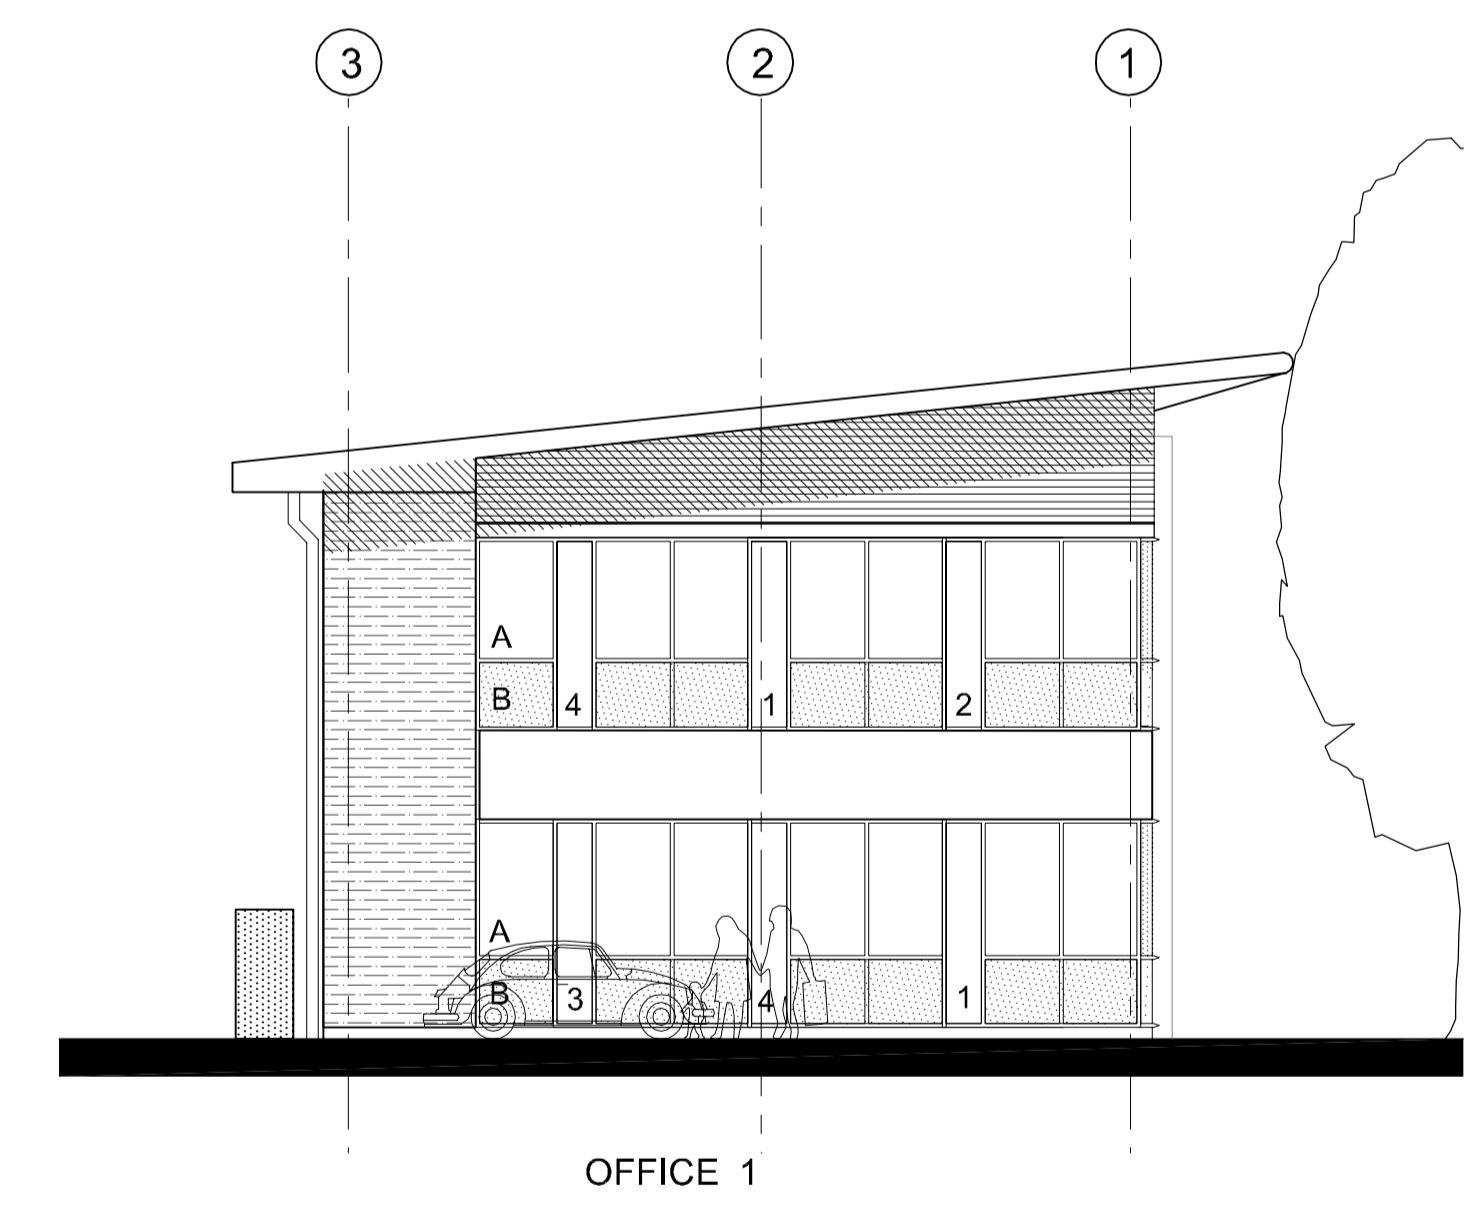

04 WATERSIDE COURT OFFICE 1-3 NORTH ELEVATION  
1108 1:100

**NOTES:**  
 SUBJECT TO STATUTORY CONSENTS  
 SUBJECT TO SURVEY  
 BASED ON OS MAP REPRODUCED BY PERMISSION OF CONTROLLER OF HM STATIONARY OFFICE (c) CROWN COPYRIGHT  
 COPYRIGHT RESERVED  
 DO NOT SCALE THIS DRAWING  
 DO NOT USE ELECTRONIC VERSIONS OF THIS DRAWING TO DETERMINE DIMENSIONS UNLESS SPECIFICALLY AUTHORISED BY MICHAEL SPARKS ASSOCIATES  
 IF USING AN ELECTRONIC VERSION OF THIS DRAWING FIGURED DIMENSIONS TAKE PRECEDENCE AND NOTIFY MICHAEL SPARKS ASSOCIATES OF ANY DISCREPANCIES

ENSURE SEALING OF ALL JUNCTIONS TO COMPLY WITH PART L.


LI: 0.15  
 Roof: 0.25  
 Floors: 0.25  
 Walls: 0.35  
 Glazing: 1.50

NOTE:  
 ROOF AND WALL CLADDING TO BE DESIGNED BY SPECIALIST CONTRACTOR.  
 CLADDING DETAILS TO BE READ IN CONJUNCTION WITH THE SPECIFICATION AND ALL RELEVANT BRITISH STANDARDS.  
 INCLUDE VAPOUR BARRIER TAPE AROUND ALL OPENINGS AND JUNCTIONS.

ALL DIMENSIONS TO BE CHECKED ON SITE.  
 STEEL COLUMN SIZES TO BE CONFIRMED AND TOLERANCES TO BE AGREED.

- A 6mm CLEAR LOW E-GLASS TOUGHENED  
16mm ARGON SPACER COMPRISING 90% ARGON  
6.4mm SOFT COAT LAMINATED
- B 6mm SATIN SANDBLASTED TOUGHENED  
16mm ARGON SPACER COMPRISING 90% ARGON  
6.4mm SOFT COAT LAMINATED
- 1 6.8mm VANCEVA LAMINATED BLUE GLASS TOUGHENED  
PANE - REF **TRUE BLUE**  
16mm ARGON SPACER COMPRISING 90% ARGON  
6mm CLEAR LOW E-GLASS TOUGHENED
- 2 6.8mm VANCEVA LAMINATED BLUE GLASS TOUGHENED  
PANE - REF **AQUAMARINE**  
16mm ARGON SPACER COMPRISING 90% ARGON  
6mm CLEAR LOW E-GLASS TOUGHENED
- 3 6.8mm VANCEVA LAMINATED BLUE GLASS TOUGHENED  
PANE - REF **SAPPHIRE**  
16mm ARGON SPACER COMPRISING 90% ARGON  
6mm CLEAR LOW E-GLASS TOUGHENED
- 4 6.8mm VANCEVA LAMINATED BLUE GLASS TOUGHENED  
PANE - REF **6166**  
16mm ARGON SPACER COMPRISING 90% ARGON  
6mm CLEAR LOW E-GLASS TOUGHENED

|   |            |   |      |     |
|---|------------|---|------|-----|
| <h1>AS BUILT</h1>   |            |   |      |     |
| THIS "AS-BUILT" DRAWING IS BASED ON INFORMATION SUPPLIED TO MICHAEL SPARKS ASSOCIATES BY MC LAREN CONSTRUCTION AND INCORPORATES INSTRUCTIONS AND OTHER DESIGN INFORMATION GIVEN TO MC LAREN CONSTRUCTION DIRECTLY BY OTHERS |            |   |      |     |
| A   | 25.03.2009 | Refer to sub-contractors drawings for specialist details<br>This supercedes drawing no: 2716/RE/307 rev.A | JH   | NSC |
| REV   | DATE       | NOTE  | DRAW | CHK |

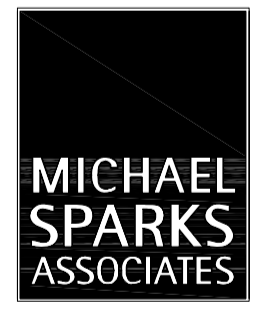

CHARTERED ARCHITECTS  
 11 PLATO PLACE  
 ST. DUNGS ROAD  
 LONDON SW6 4TU  
 TELEPHONE 020 7736 6162  
 FAX 020 7736 3896  
 www.msa-architects.co.uk

## FROGMORE

TITLE  
**CROSSWAYS, DARTFORD**

DRAWING  
**WATERSIDE COURT OFFICE 1-3 ELEVATIONS**

CLIENT  
**FROGMORE**

|                                     |                     |                |
|-------------------------------------|---------------------|----------------|
| DATE<br>MARCH 2009                  | SCALE<br>1:100 @ A1 | DRAWN<br>JH    |
| STATUS<br>AS BUILT                  |                     | CHECKED<br>NSC |
| DRAWING NUMBER<br>2716 / AB / 1108A |                     |                |